


Insight Design Ltd Copyright. This drawing and design and all the information contained therein is the sole copyright of Insight Design Ltd and reproduction in any form is forbidden unless permission is obtained in writing.

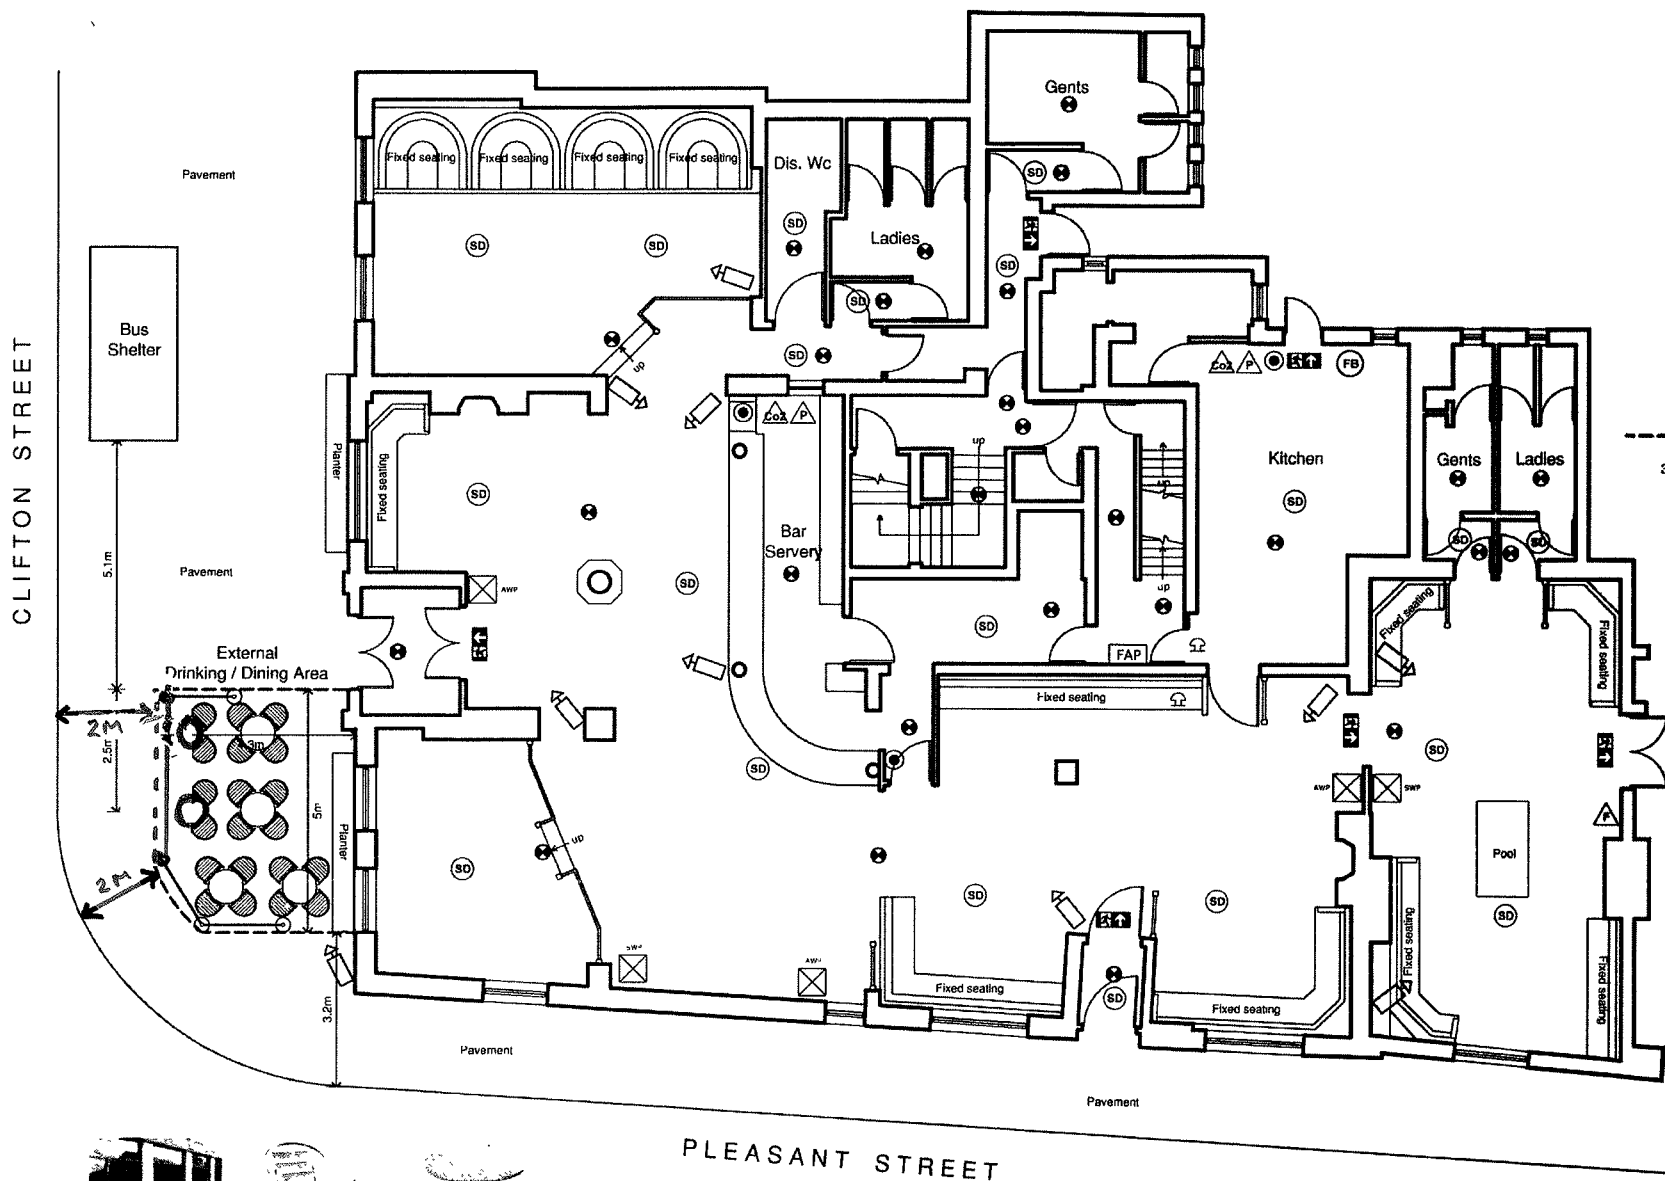

- (FB) Fire Blanket
- (A) Water extinguisher
- (A) Dry powder extinguisher
- (A) Foam extinguisher
- (A) Co2 extinguisher
- (SD) Smoke detector
- (EXIT) Illuminated exit sign to current legislation
- (B) Break glass alarm point
- (A) Alarm scunner
- (E) Emergency Light
- Licensed Area
- 30FD = Indicates 30min fire resistant door with smoke seals and self closing door closer.
- (FAP) Fire alarm panel
- (CCTV) CCTV camera

|                                                                                                                                                                                                                                                                        |                              |                           |     |
|------------------------------------------------------------------------------------------------------------------------------------------------------------------------------------------------------------------------------------------------------------------------|------------------------------|---------------------------|-----|
| B                                                                                                                                                                                                                                                                      | Dimensions as-built          | 08/10/14                  | ADH |
| A                                                                                                                                                                                                                                                                      | Dimensions & furniture added | 03/10/14                  | ADH |
| <small>DO NOT SCALE. WRITTEN DIMENSIONS TO BE USED IN PREFERENCE TO SCALED DIMENSIONS. ALL DIMENSIONS TO BE CHECKED ON SITE BY CONTRACTORS &amp; ALL DISCREPANCIES TO BE REPORTED TO THE DESIGNER.</small>                                                             |                              |                           |     |
| <b>JOB TITLE</b><br>SHIP & ROYAL<br>91 CLIFTON STREET<br>LYTHAM, ST. ANNES<br>LANCOS FY8 5EH                                                                                                                                                                           |                              |                           |     |
| <b>DRAWING TITLE</b><br>PROPOSED LICENSING PLAN                                                                                                                                                                                                                        |                              |                           |     |
| <b>SPIRIT PUB COMPANY</b>                                                                                                                                                                                                                                              |                              |                           |     |
| SCALE<br>1:100 @ A3                                                                                                                                                                                                                                                    |                              | DRAWING NO<br>1936 / L01B |     |
| DATE<br>JULY 2014                                                                                                                                                                                                                                                      |                              |                           |     |
| DRAWN BY<br>ADH                                                                                                                                                                                                                                                        |                              |                           |     |
|                                                                                                                                                                                                                                                                        |                              |                           |     |
| <small>UNIT 14 PONDERSDA BUSINESS PARK<br/>         BATHFES LANE, HECROCHAMPE<br/>         WEST YORKSHIRE WF16 0PR<br/>         UK<br/>         T. 01924 411737 F. 01924 411847<br/>         e. admin@insightdesign.co.uk<br/>         www.insightdesign.co.uk</small> |                              |                           |     |



Banner style ponmotor



Chair style



Table style